

Client:	Waipa Dist. Council		
Job:	Kihikihī Sewerage Upgrade		
Property Plan No:	C695	Catchment:	No 6-
Street:	Shaehan No. 17a	Lot:	DPS:
Owner:	4532/826-00	Drainlayer:	R. N. Steele
Inspector:	A Kwaimani	Reg No.:	04189
Date of Inspection:	26-4-06.	Consent No.:	
Drainlayer Please Fill in All Details			


As Built Property Plan

FILE COPY

ENTERED

40.7m

COPY

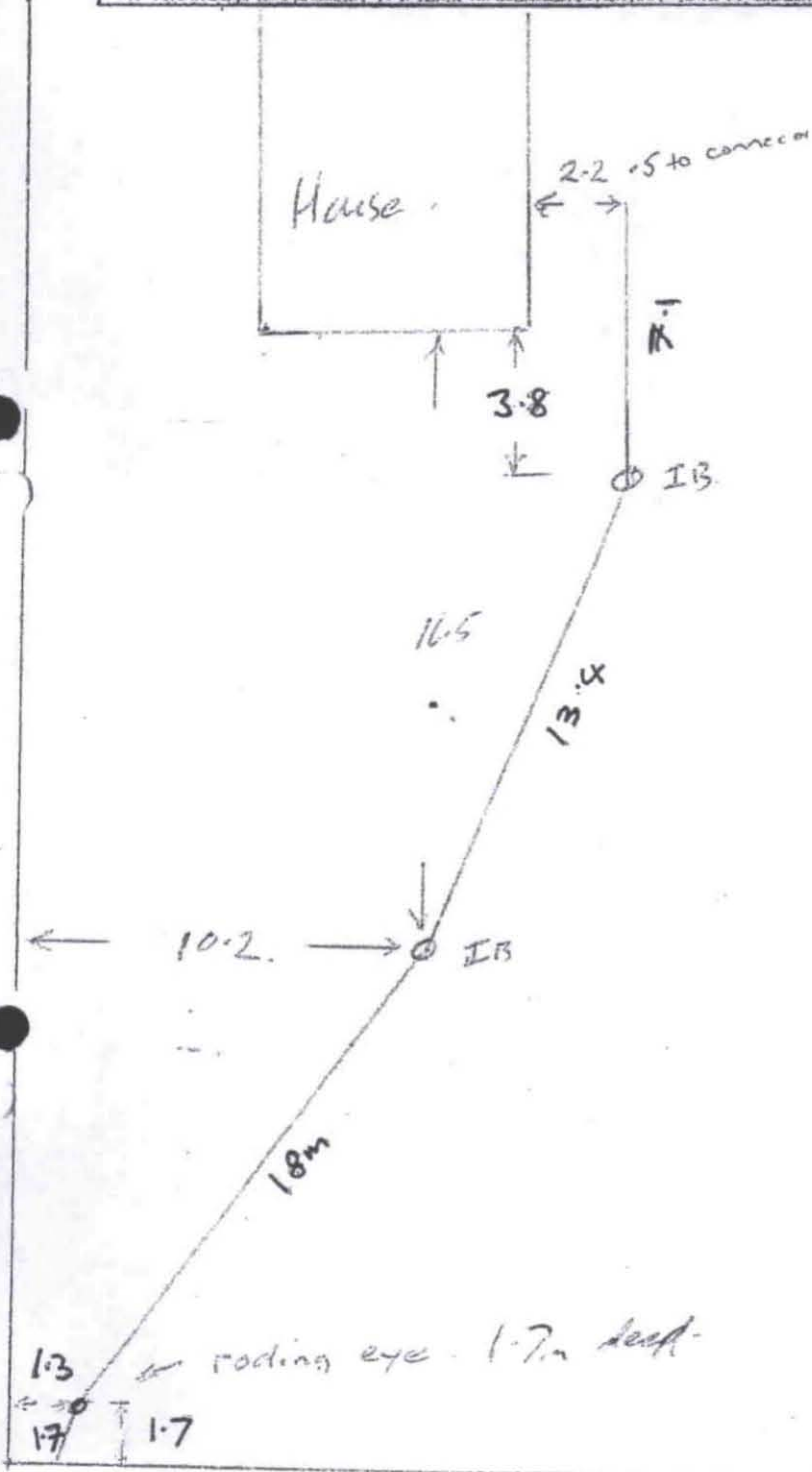

Drainlayer's Signature:

R.N. Steele

Date:

26-4-06.